


DATE	ISSUED FOR	BY
AUG 10/09	ISSUED FOR COMMENTS	
AUG 31/09	SHOP DRAWINGS	
OCT 29/09	AS-CONSTRUCTED	

- IRRIGATION LEGEND**
- ⊕ RANBRID ESP LXM MODULAR TIMER
 - ⊠ 2" WATER SOURCE
 - ⊕ RANBRID PE3150 AUTO VALVE
 - ⊕ RANBRID 7005 ROTOR, #18 NOZZLE
 - RANBRID 1804 SPRAY
 - RANBRID No.5 QUICK COUPLING VALVE
 - ▲ 1" ARKAL DISC FILTER
 - TREES - PREPLANT LOOP AT 3' RADIIUS BURIED 4" BELOW SURFACE

SEAL

CENTENNIAL PARK
CITY OF DUNCAN

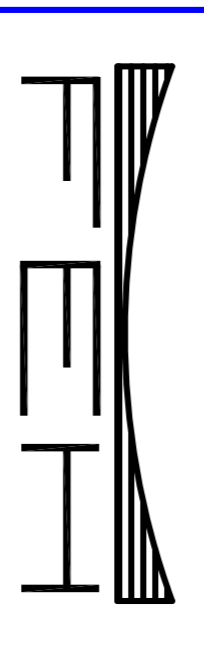

Irrigation Design Services
• Wichita • Salina • Columbia •
1440 East 29th Street, Salina, KS 67401
P: (781) 650-1115 Fax: (781) 650-0277

DRAWN BY: FEH.
DESIGNED BY: FEH.
CHECKED BY: DMH.
DATE: OCT 29, 2009

SCALE: 1:250
DRAWING TITLE:
IRRIGATION PLAN AND DETAILS
ASBUILT

REVISION: C
DRAWING NO.: **1283**